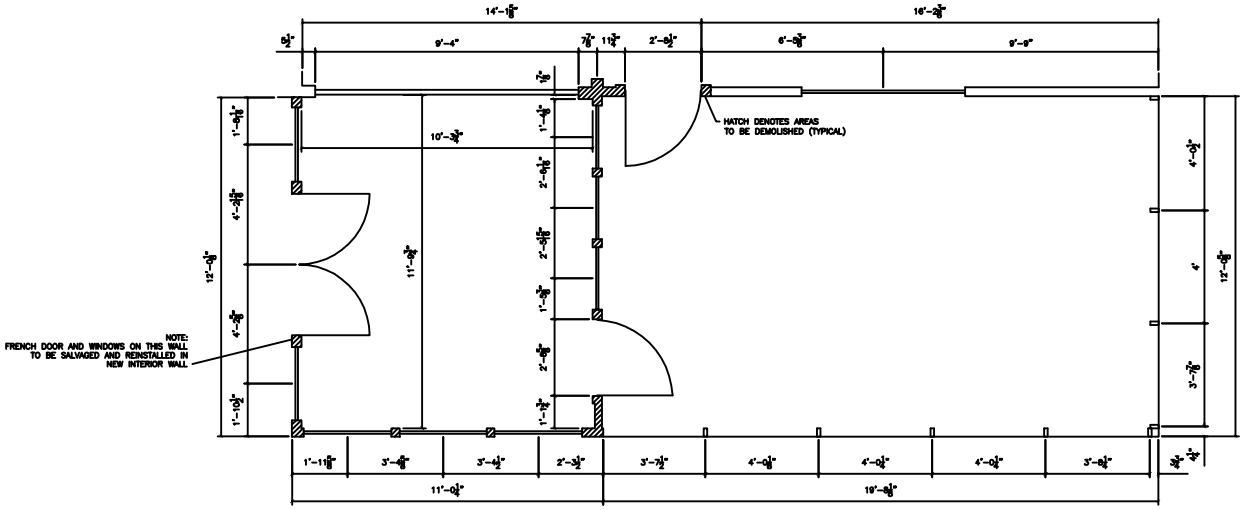

1/1 AS BUILT FLOOR PLAN
SCALE: 1/2" = 1'-0"

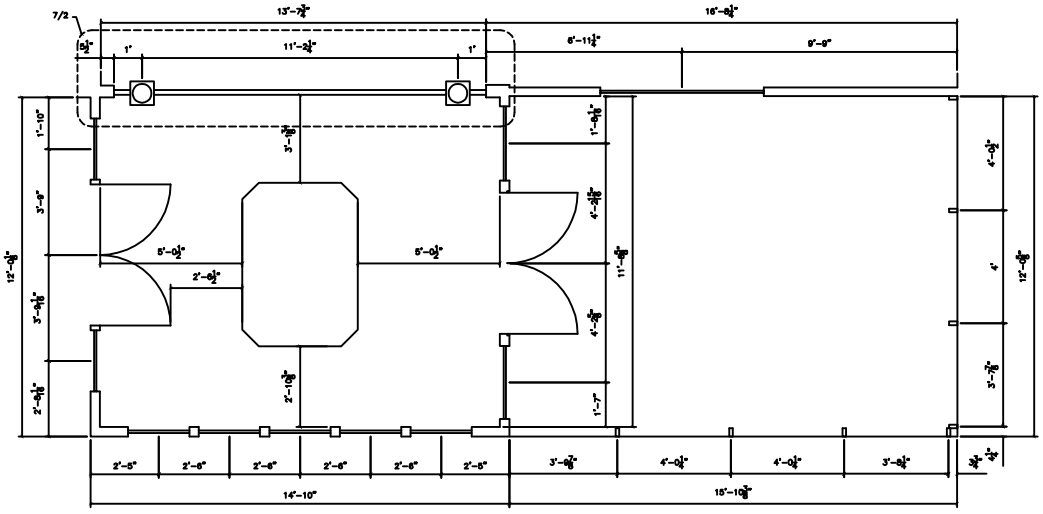

2/1 PROPOSED FLOOR PLAN
SCALE: 1/2" = 1'-0"

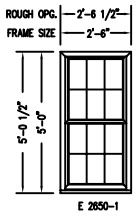

3/1 WINDOW DETAIL
SCALE: 1/2" = 1'-0"

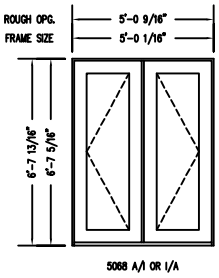

4/1 FRENCH DOOR DETAIL
SCALE: 1/2" = 1'-0"